



LOCATION MAP
SCALE 1:50,000



Fig 1. ELEVATION OF STRUCTURE



Fig 2. Proposed Site Location

SITE PHOTOGRAPHS

15m ALPHA 2.0 STREETPOLE

SITE COORDINATES

LATITUDE: 53°16'58.55" N	IG EASTING: 133,306.8	ITM EASTING: 533,172.8
LONGITUDE: 0°07'27.77" W	IG NORTHING: 226,316.5	ITM NORTHING: 726,345.4

A	INITIAL ISSUE	18/08/20	AW	JR
No.	Revision	Date	By	Chd

Deimec

Deimec Engineering Limited
10 Barrowside Business Park,
Skealy Road, Graiguecullen, Co. Carlow

cellnex
driving telecom connectivity

Signal Infrastructure Ltd.
Suite 311, O House, 76 Furze Road,
Sandyford Industrial Estate, Dublin 18,
D18 YV50, IRELAND

Jason Redmond & Associates Consulting Engineers



Civil Structural
Project Management
5 Lisnard Court, Portlaoise,
Co. Laois.
PH: 05786 81155
Email: info@jrasc.ie

AS BUILT

Signal site ID: CIG-01065

Operator site ID: GY_1667


Site Name
BALLYBANE STREETWORKS
CO. GALWAY

Title
MOBILE TELECOMS INSTALLATION
LOCATION MAP & PHOTOGRAPHS

Designed JR Date 18.08.2020

Drawn AW Scale 1:50,000 Rev. A

Dwg No. GY_1667-500

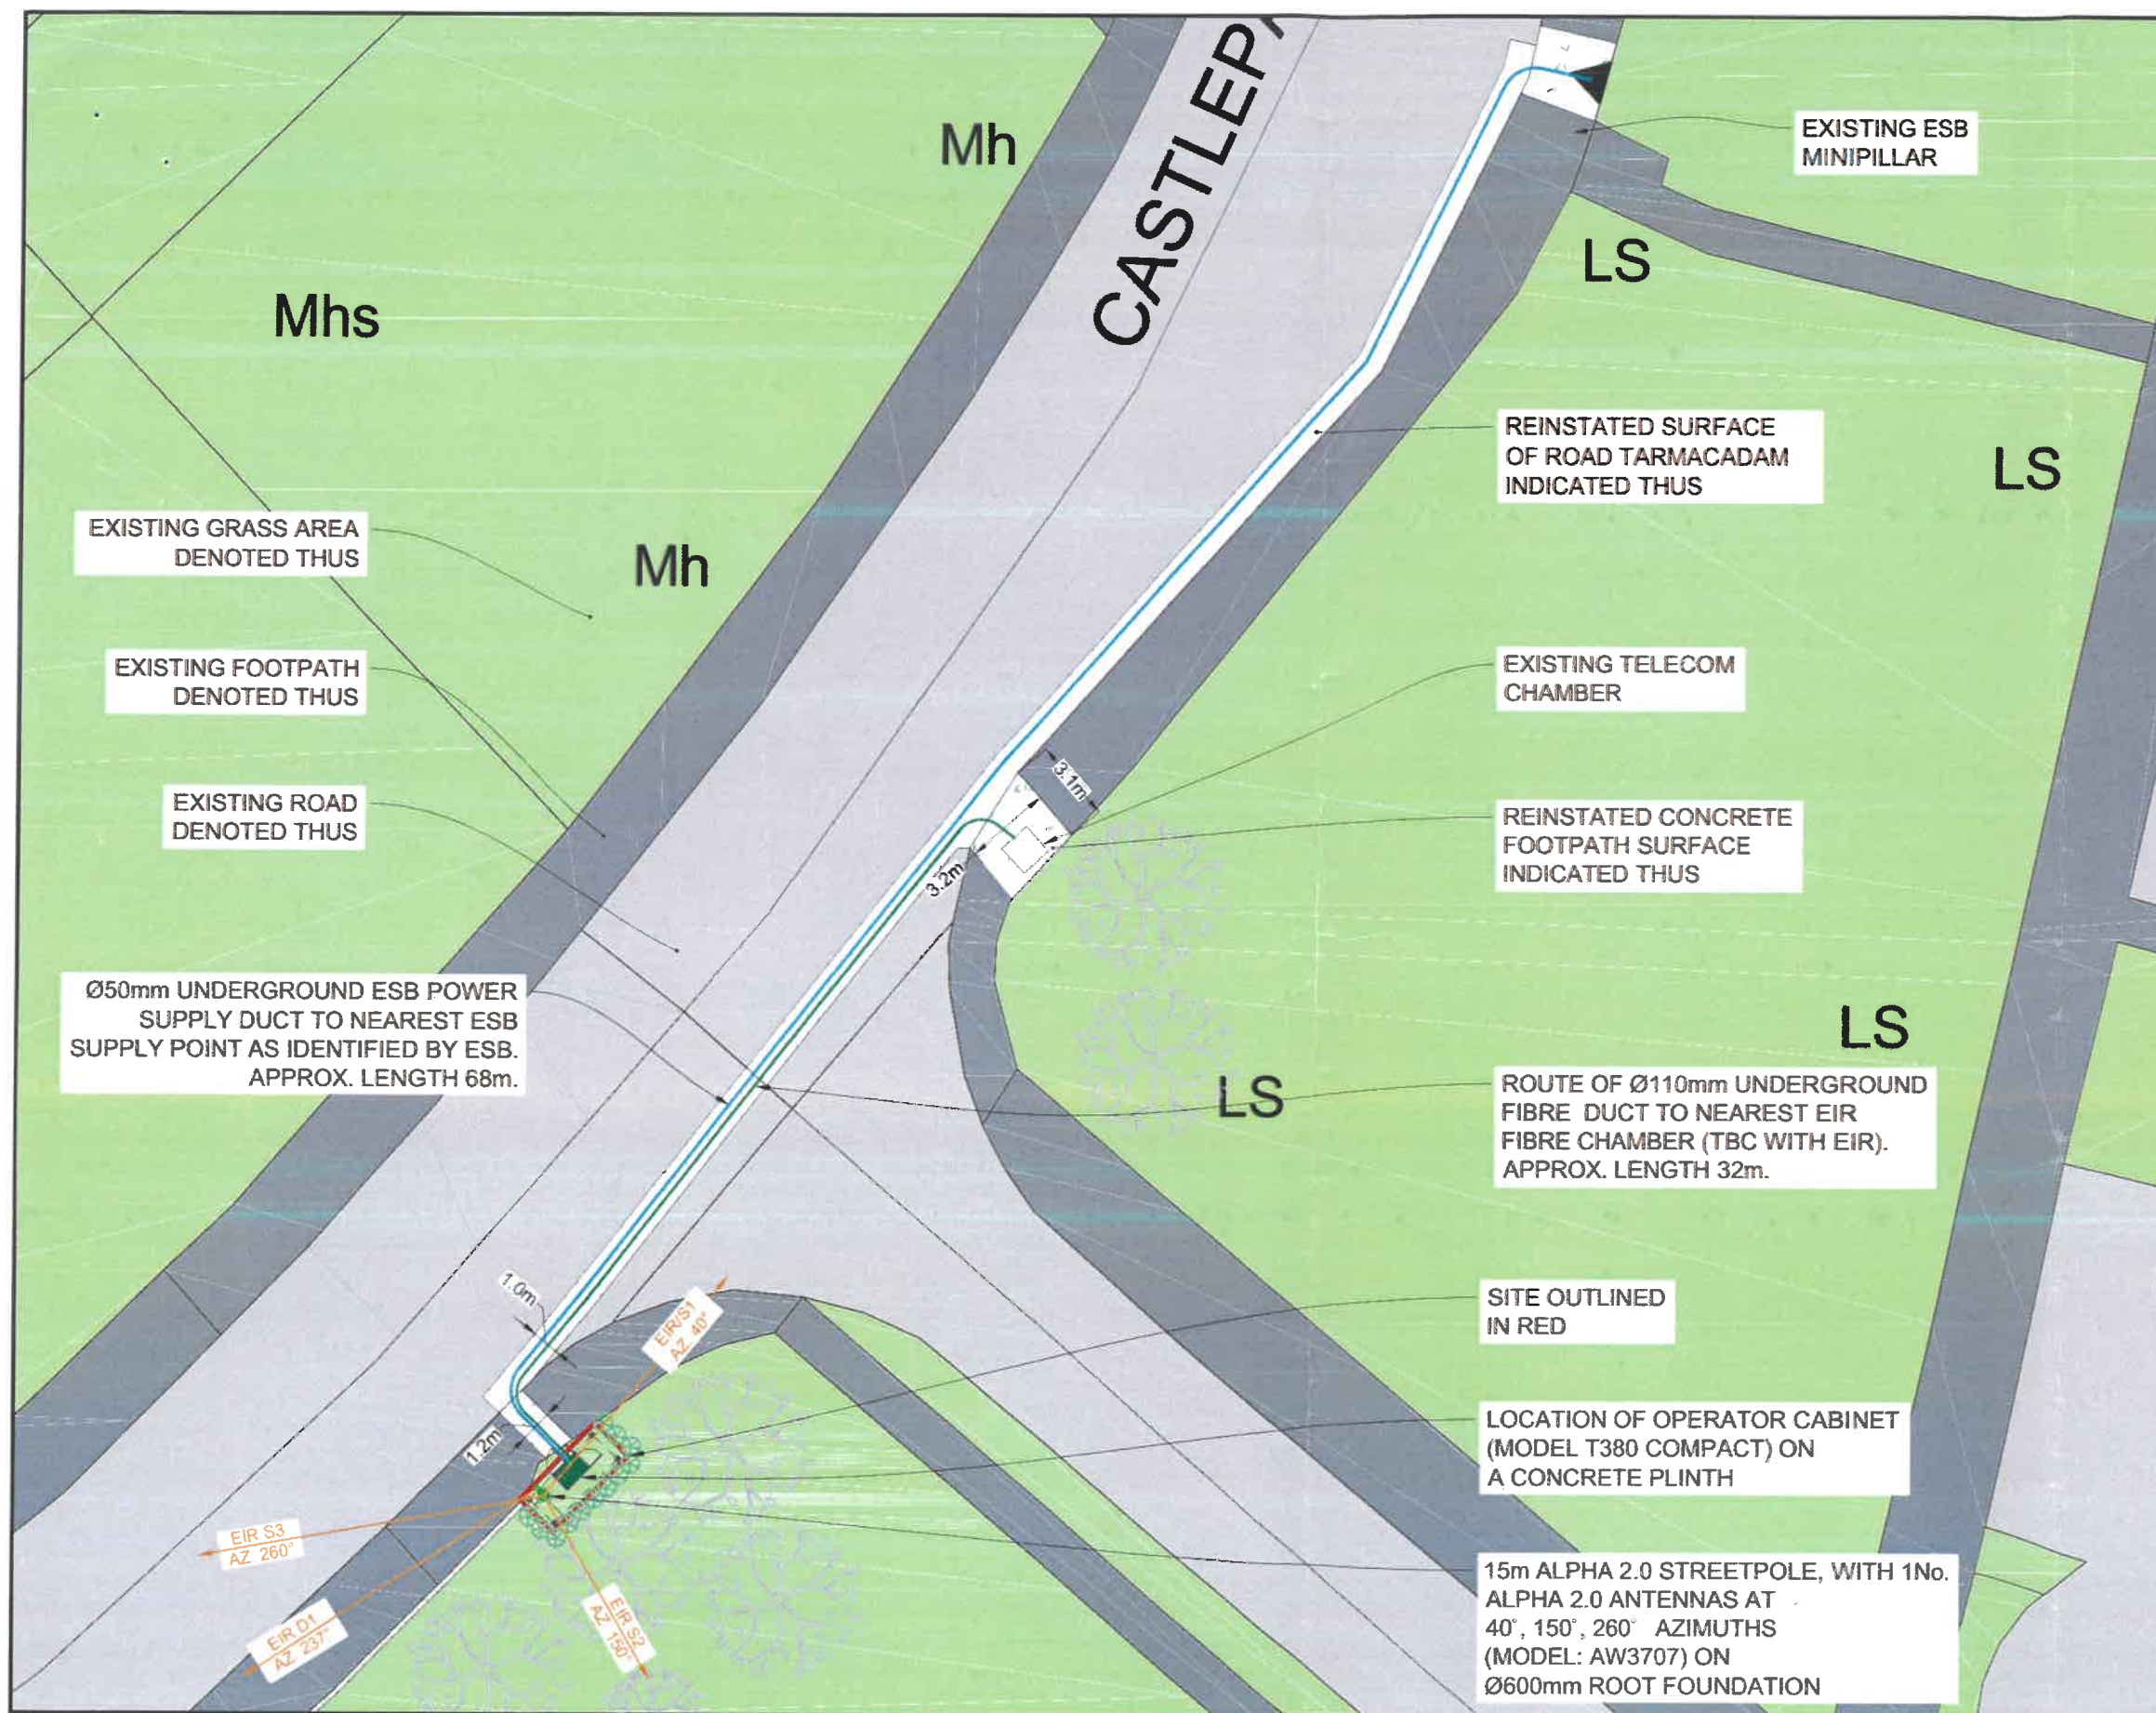

SITE LAYOUT

SCALE 1:250

15m ALPHA 2.0 STREETPOLE

GENERAL NOTES

1. Do not scale.
2. All dimensions to be in mm unless specified otherwise.
3. This drawing read in conjunction with the relevant scope of works and all relevant engineers and specialist drawings.
4. All works to be in accordance with the relevant and current health and safety legislation.
5. Specification of the works to be to the appropriate Irish standard or the equivalent British standard.
6. All works to be carried out in strict accordance with project specifications.
7. Civils contractor to carry out a thorough cat scan of the area per the best code of practice for avoiding danger from underground services prior to proceeding with any excavation.
8. Hand dig to determine exact location, depth and nature of any existing buried services. Contractor to identify, expose and adequately protect any existing buried cables.
9. If in any doubt contact the relevant 'dial before you dig' helpline.

SITE COORDINATES

LATITUDE:	53°18'56.55" N	IG EASTING:	133,288.8	ITM EASTING:	533,172.8
LONGITUDE:	9°17'7.77" W	IG NORTHING:	226,346.5	ITM NORTHING:	726,346.4



A	INITIAL ISSUE	18/08/20	AW	JR
No.	Revision	Date	By	Chd

Deimec

Deimec Engineering Limited
10 Barnwood Business Park,
Sleaty Road, Graiguecullen, Co. Carlow

cellnex
driving telecom connectivity

Signal Infrastructure Ltd.
Suite 311, Q House, 76 Furze Road,
Sandford Industrial Estate, Dublin 18,
D18 YV50, IRELAND.

Jason Redmond & Associates Consulting Engineers

Civil Structural
Project Management
5 Lisnard Court, Portlaoise,
Co. Laois.
PH: 05766 81155
Email: info@jra.ie

AS BUILT


Signal site ID: CIG-01065

Operator site ID: GY_1667

Site Name
**BALLYBANE STREETWORKS
CO. GALWAY**

Title
**MOBILE TELECOMS INSTALLATION
SITE LAYOUT**

Designed	JR	Date	18/08/20
Drawn	AW	Scale	1:250
Dwg No.	GY_1667-501	Rev.	A

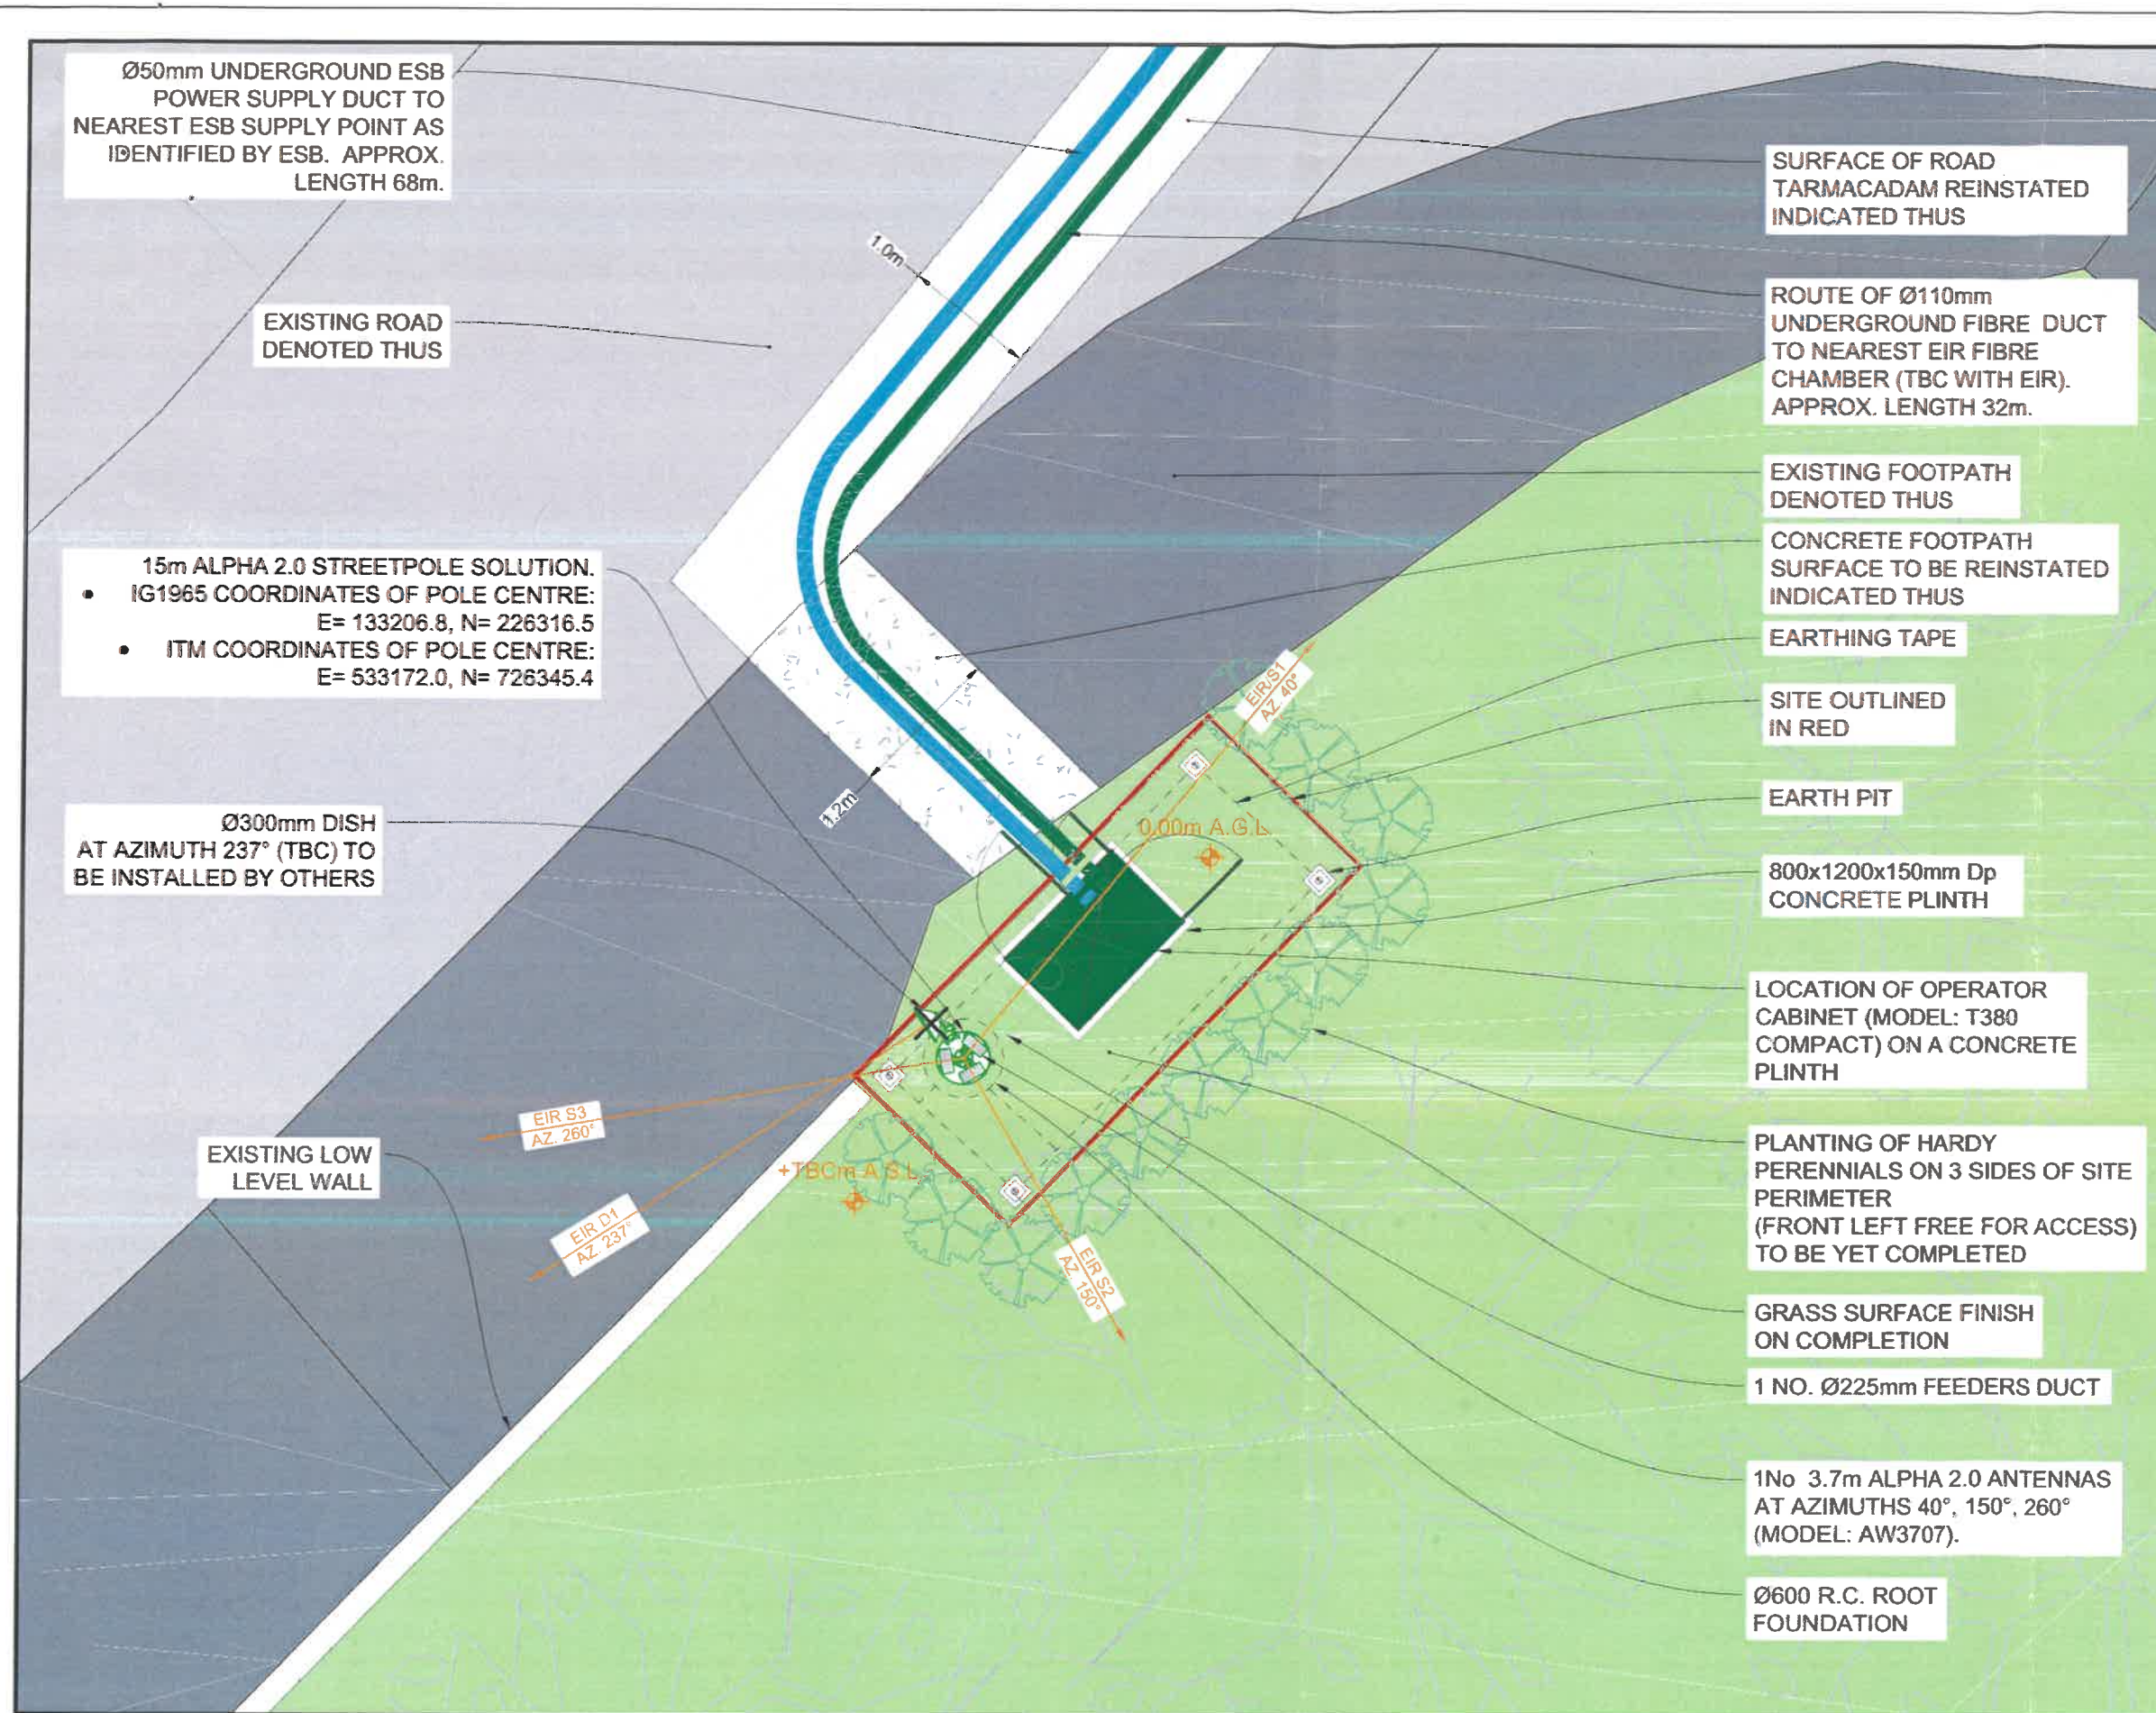

SITE LAYOUT PLAN

SCALE 1:50

THIS DRAWING IS THE PROPERTY OF JRA AND MUST NOT BE COPIED, TRACED OR REPRODUCED WITHOUT THEIR PERMISSION.

15m ALPHA 2.0 STREETPOLE

SCHEDULE OF RT DISHES

OPERATOR	DISH I.D.	HEIGHT [m]	BEARING	DISH DIA. [mm]	FAR END LINK
EIR	D1	9.9	237° (TBC)	300	GY_3957 Plannerys Hotel

SCHEDULE OF SECTOR ANTENNAS

OPERATOR	SECTOR I.D.	AERIAL I.D.	HEIGHT [m]	BEARING	ANTENNA TYPE
EIR	S1	ANT 1	15.0	40°	3.7m Alpha 2.0 (MODEL: AW3707)
EIR	S2	ANT 2	15.0	150°	3.7m Alpha 2.0 (MODEL: AW3707)
EIR	S3	ANT 3	15.0	260°	3.7m Alpha 2.0 (MODEL: AW3707)



A	INITIAL ISSUE	DATE	BY	CHKD
No.	Revision	Date	By	Chkd

Deimec

Deimec Engineering Limited
10 Barrowside Business Park,
Slieve Road, Graiguecullen, Co. Carlow

cellnex
driving telecom connectivity

Cignal Infrastructure Ltd.
Suite 311, Q House, 76 Furze Road,
Sandyford Industrial Estate, Dublin 18,
D18 YV50, IRELAND.

Jason Redmond & Associates Consulting Engineers

Civil Structural
Project Management
5 Lisnard Court, Portlaoise,
Co. Laois.
PH: 05786 81155
Email: info@jrasc.ie

AS BUILT

Signal site ID CIG-01065

Operator site ID GY_1667


Site Name
BALLYBANE STREETWORKS
CO. GALWAY

Title
MOBILE TELECOMS INSTALLATION
PLAN VIEW

Designed JR Date 18.08.2020

Drawn AW Scale 1:50 Rev. A

Dwg No. GY_1667-502

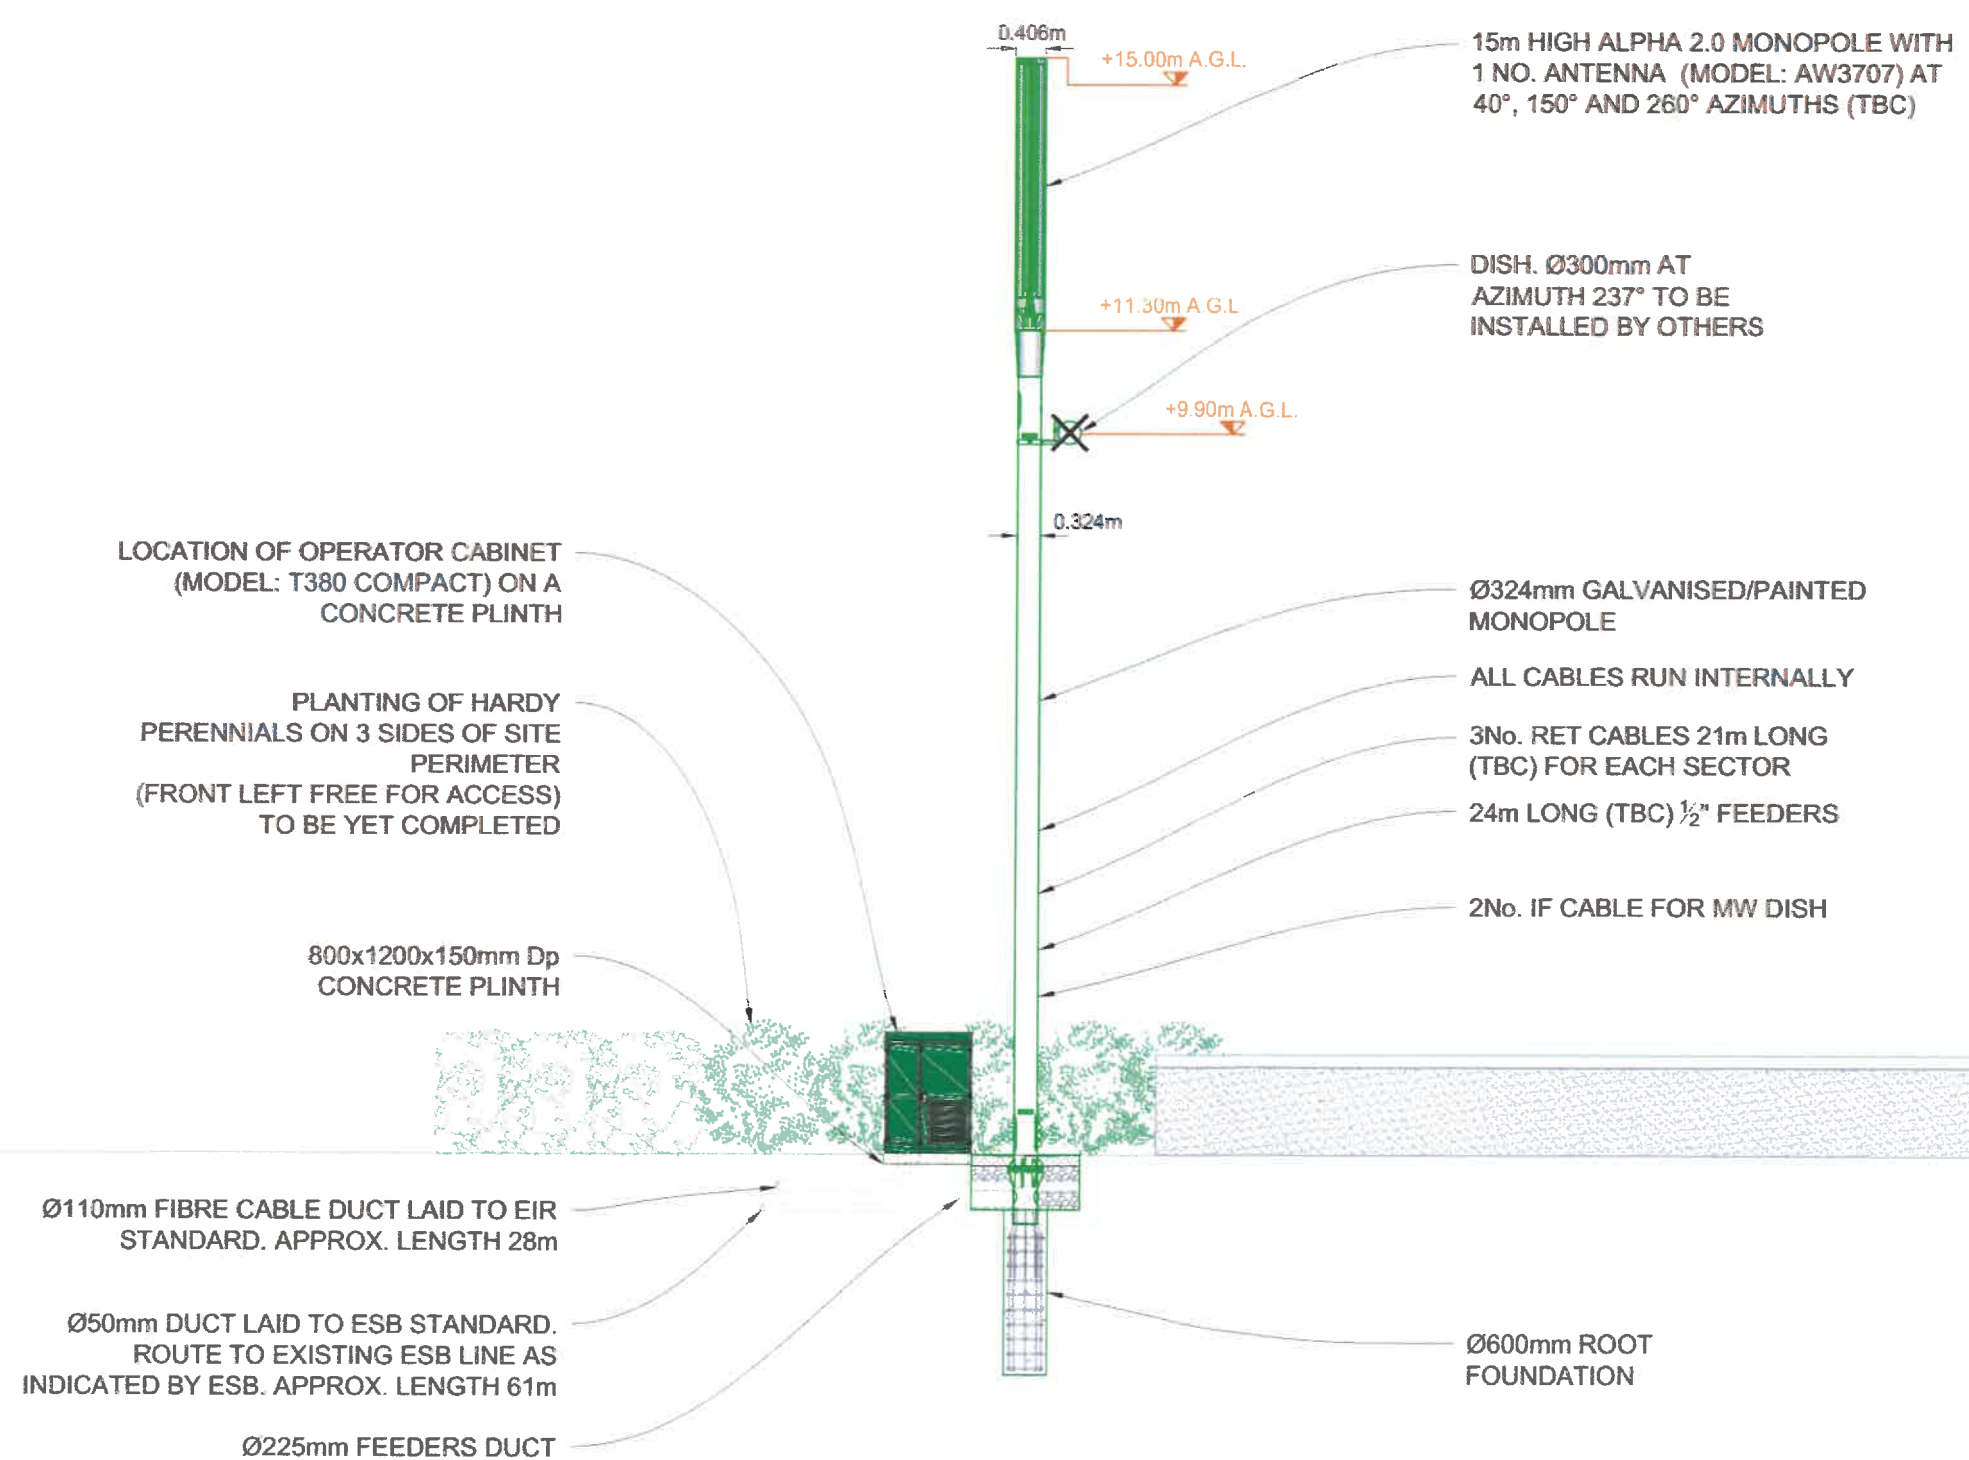

ELEVATION
SCALE 1:100

15m ALPHA 2.0 STREETPOLE

SCHEDULE OF RT DISHES

OPERATOR	DISH I.D.	HEIGHT [m]	BEARING	DISH DIA. [mm]	FAR END LINK
EIR	D1	11.55	237° (TBC)	300	GY_3857 Flannerys Hotel

SCHEDULE OF SECTOR ANTENNAS

OPERATOR	SECTOR I.D.	AERIAL I.D.	HEIGHT [m]	BEARING	ANTENNA TYPE
EIR	S1	ANT 1	15.0	40°	3.7m Alpha 2.0 (MODEL: AW3707)
EIR	S2	ANT 2	15.0	190°	3.7m Alpha 2.0 (MODEL: AW3707)
EIR	S3	ANT 3	15.0	260°	3.7m Alpha 2.0 (MODEL: AW3707)

A	INITIAL ISSUE	10/08/20	AW	JR
No.	Revision	Date	By	Chd



Deimec Engineering Limited
10 Barrowside Business Park,
Sleaty Road, Graiguecullen, Co. Carlow



Signal Infrastructure Ltd.
Suite 311, Q House, 76 Furze Road,
Sandyford Industrial Estate, Dublin 18,
D18 YV50, IRELAND.

Jason Redmond & Associates Consulting Engineers

Civil Structural
Project Management
2 Lismanor Court, Portlaoise,
Co. Laois.
PH: 05786 81155
Email: info@jrasac.ie

AS BUILT

Signal site ID CIG-01065

Operator site ID GY_1667

Site Name
BALLYBANE STREETWORKS
CO. GALWAY

Title
MOBILE TELECOMS INSTALLATION
ELEVATION

Designed	JR	Date	10/08/20
Drawn	AW	Scale	1:100
Dwg No.	GY_1667-503	Rev.	A