



Comhairle Cathrach na Gaillimhe
Galway City Council

ACTIVE TRAVEL OFFICE

Memo

Date: 08 May 2026
To: Jason Roache Planning Development Control
From: Active Travel Unit
Ref No: S254 Application TI 2-26 Pheonix Tower International -Section 254 Renewal licence -

RE: S254 Application TI 2-26 Pheonix Tower International -Section 254 Renewal licence -
Application for Telecommunications Infrastructure- Castlepark Road, Ballybane, Galway City

A Chara,


Please see attached the comments of the Active Travel Unit in relation to the proposed development at Castlepark Road, Ballybane, Galway City (Ref TI-2-26).

Comments:

The Active Travel Office note this is an existing Section 254 licence (granted by An Bord Pleanála) and have no comments in regard to renew of licence.

Prepared By: *Jarlath Moloney* Jarlath Moloney (S.E.Technician)

Approved by: *Patrick McCormack* Patrick McCormack Senior Executive Engineer

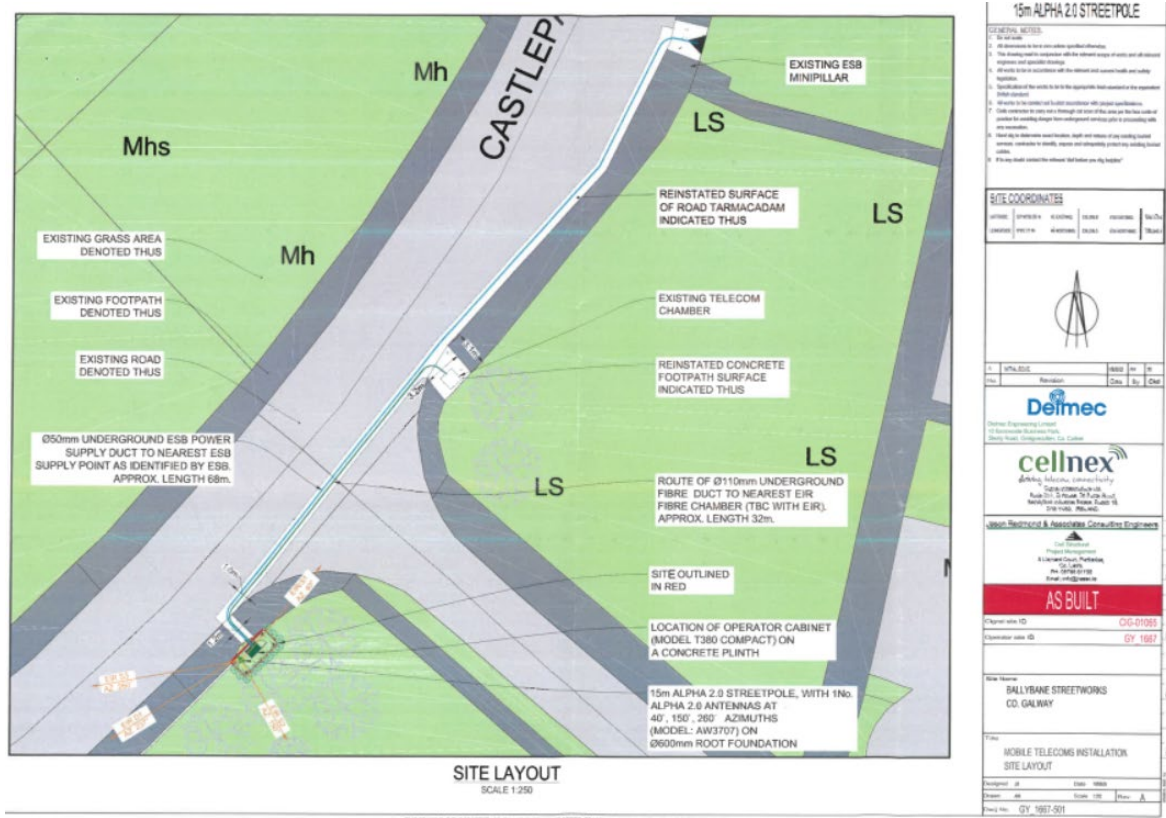

As Built Drawing of Site location



Google Image